

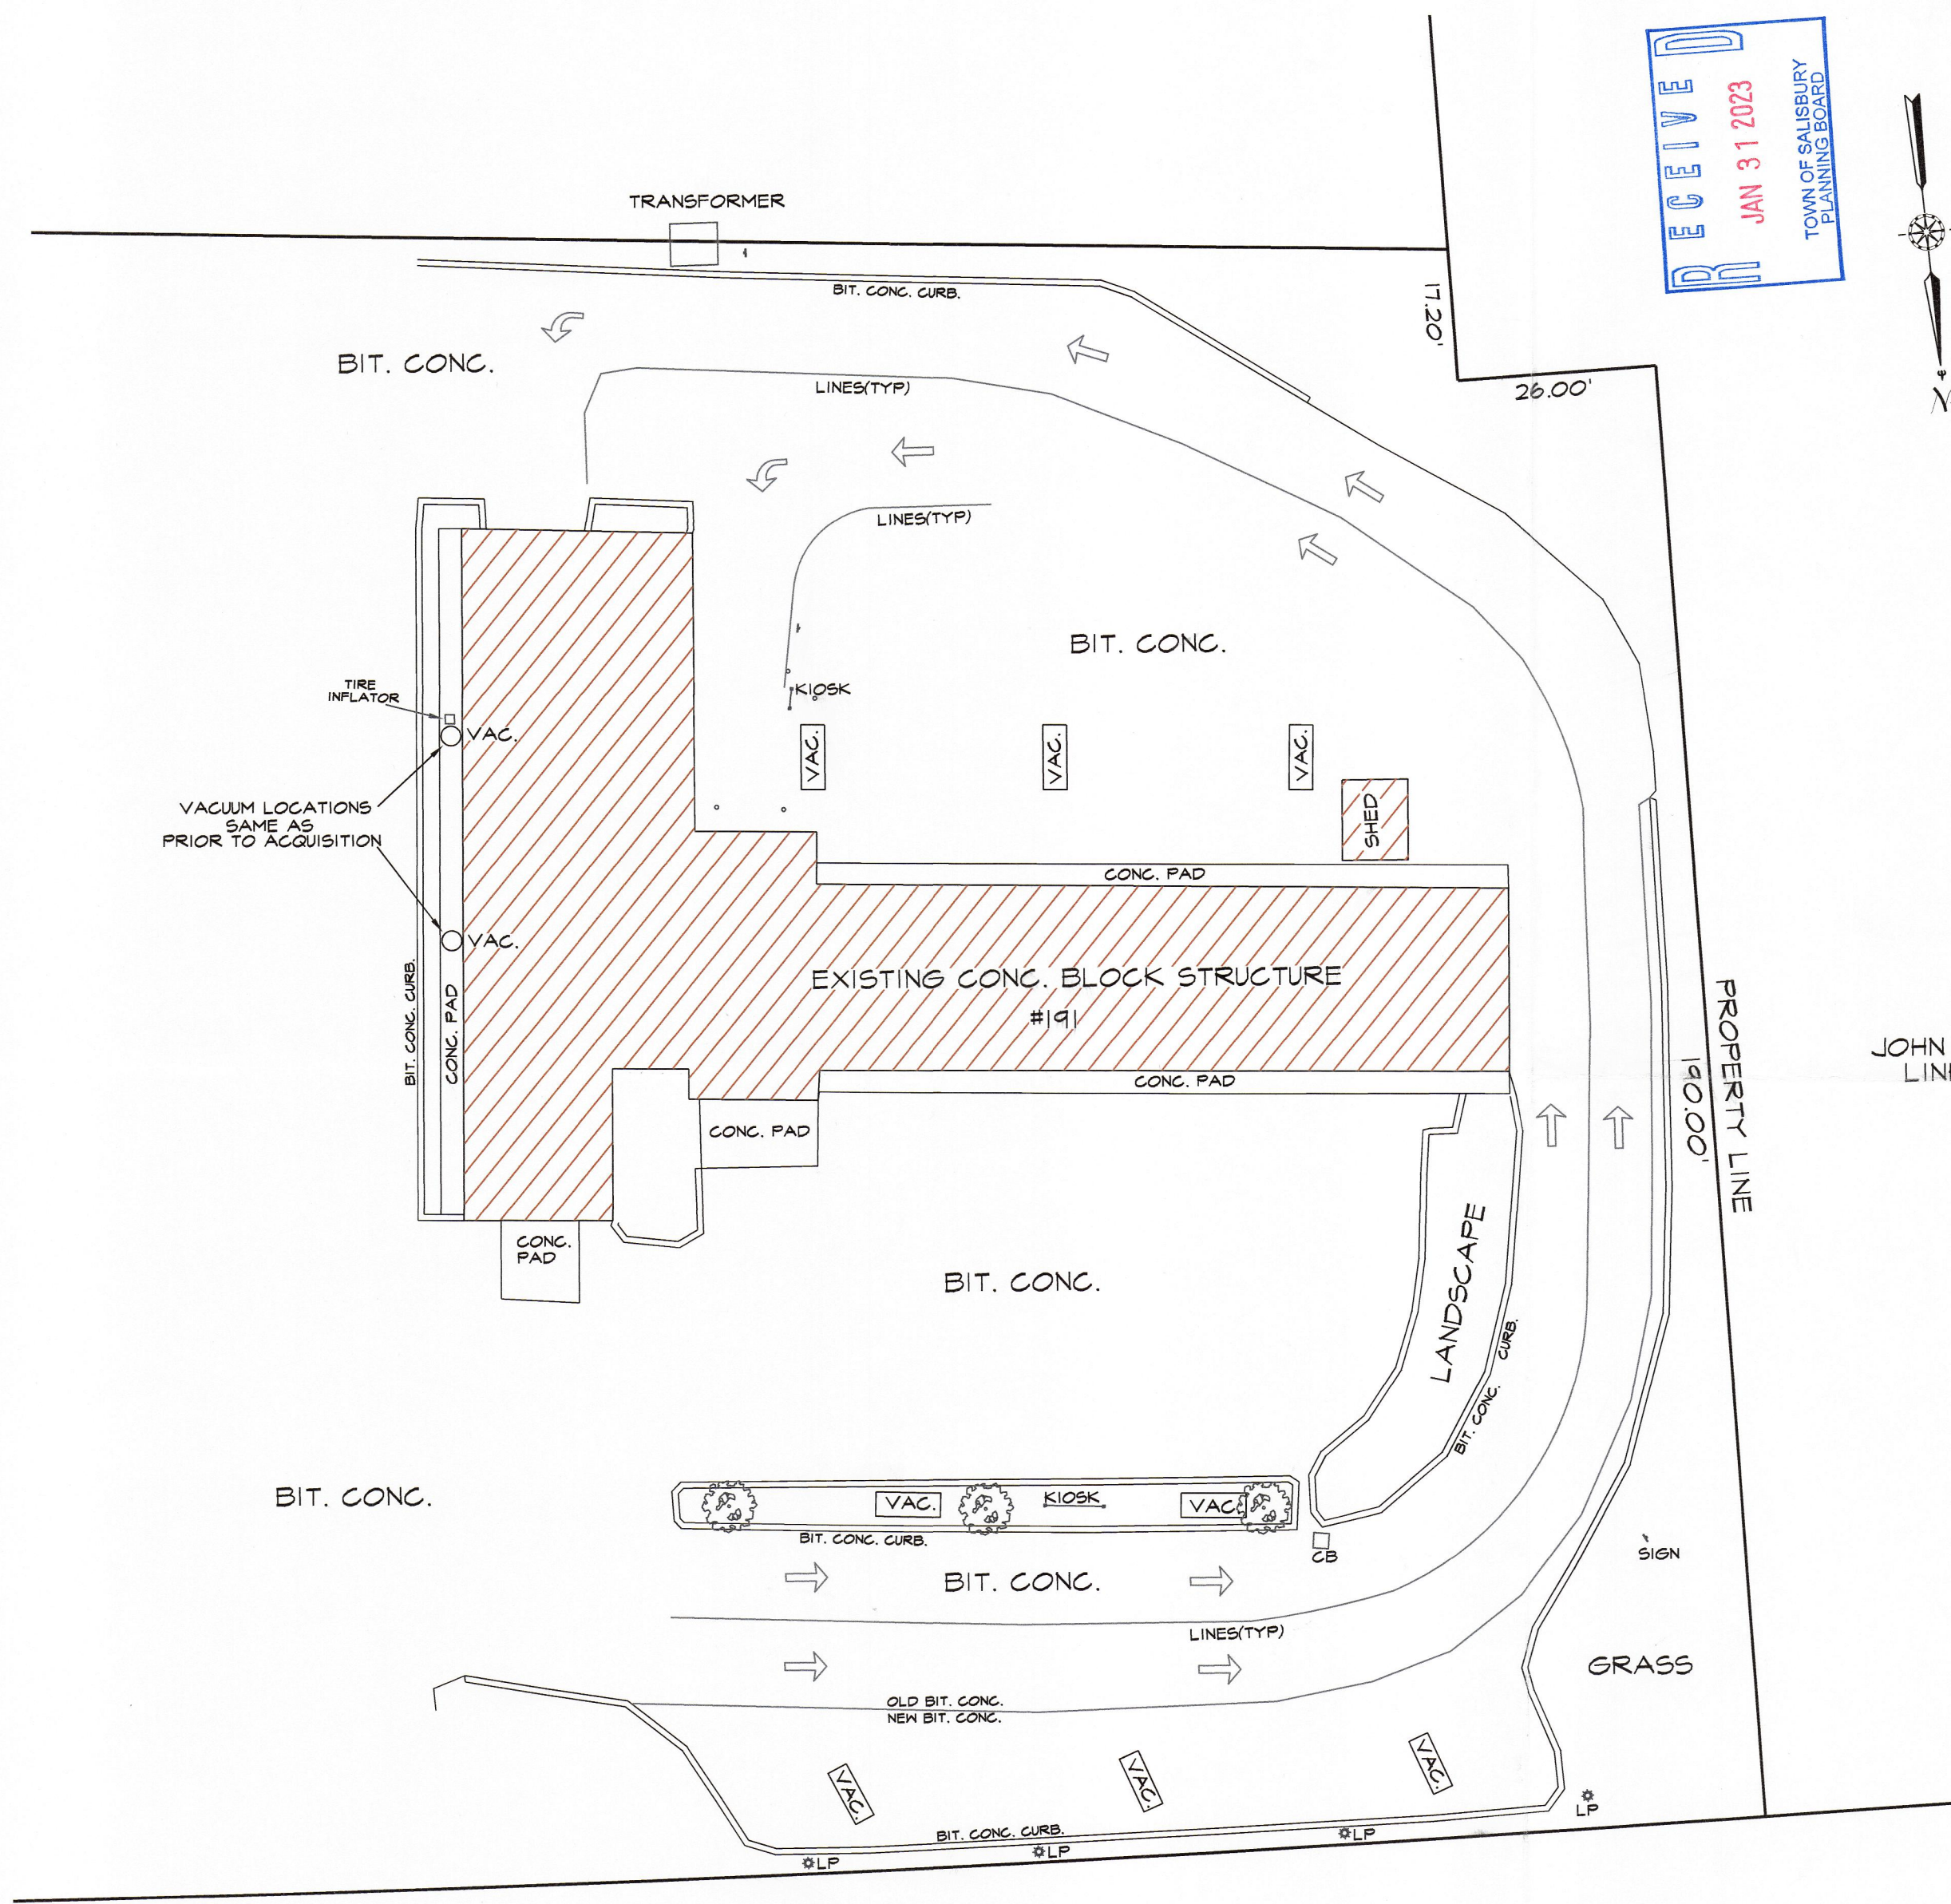


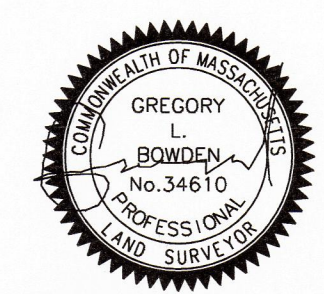

RECEIVED
JAN 31 2023
TOWN OF SALISBURY
PLANNING BOARD

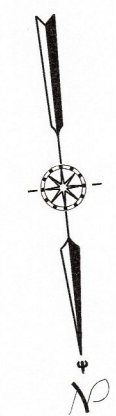

1/27/23
GREGORY L. BOWDEN P.L.S. DATE

REVISIONS	
DATE	DESCRIPTION

Northpoint Survey Services, Inc.

Surveyors
PO Box 1226
Newburyport, MA. 01950
(978) 372-0835

AS-BUILT PLAN
IN
SALISBURY, MA.

SHOWING:
191 ELM STREET, SALISBURY, MA.

PREPARED FOR:
SALISBURY CAR WASH AND DETAIL CENTER
191 ELM STREET, SALISBURY, MA. 01952

DATE: 1-27-23

SCALE: 1" = 20'

PROJECT 4491.00

**ELM STREET
ROUTE 110**
PUBLIC - WIDTH VARIES

