



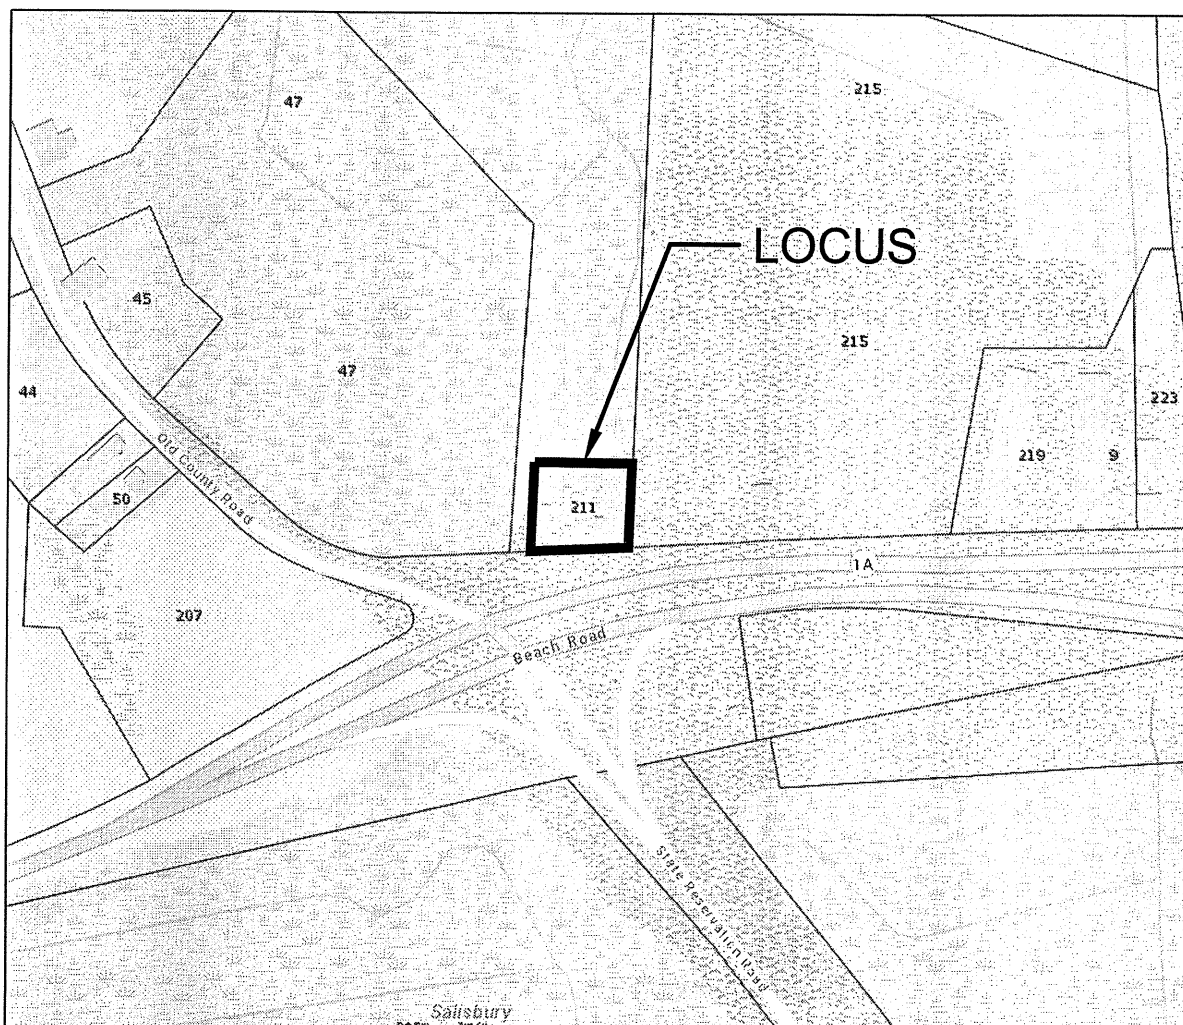



LOCUS MAP
NOT TO SCALE

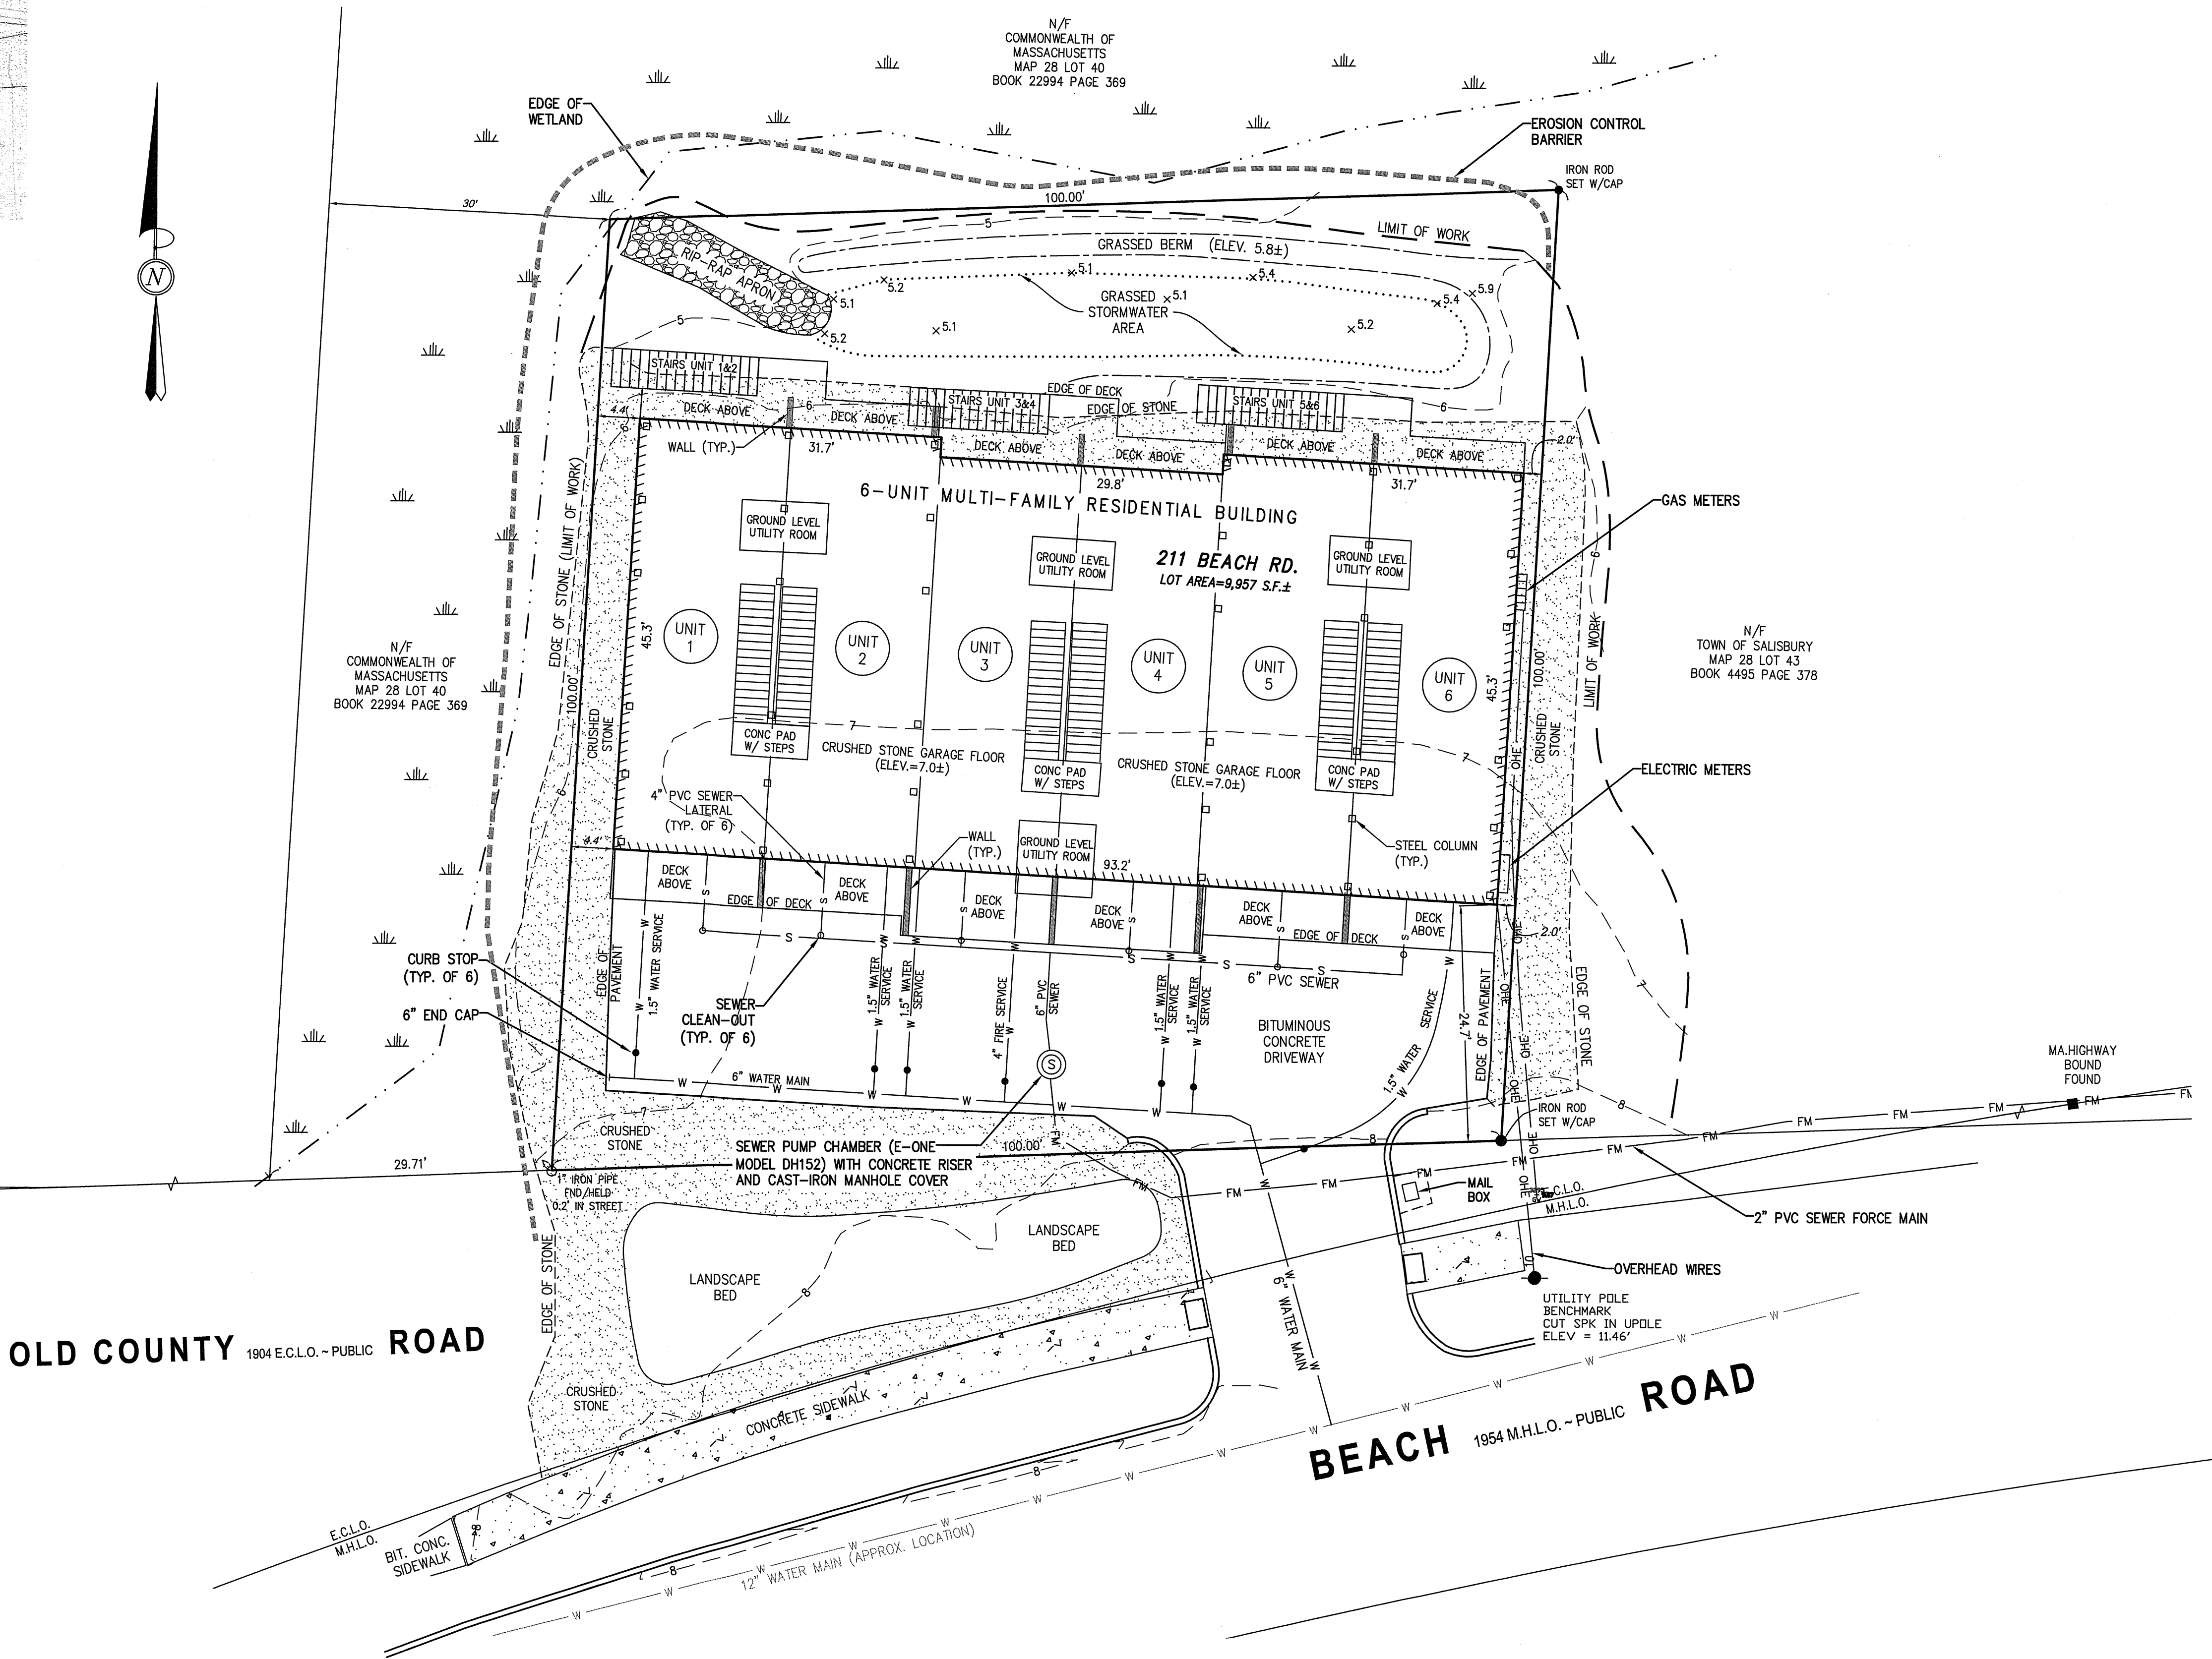

FLOOD NOTE:
THE SUBJECT PROPERTY IS LOCATED IN A ZONE AE (ELEVATION 9.0) AS ILLUSTRATED ON THE FLOOD INSURANCE RATE MAP COMMUNITY PANEL NO. 25009C0-129F, WHICH HAS AN EFFECTIVE DATE OF JULY 3, 2012.

BURIED UTILITY NOTE:
UTILITY LOCATIONS SHOWN HEREON ARE BASED ON INFORMATION PROVIDED BY THE SITE CONTRACTOR AND ON SURVEYED LOCATIONS OF VISIBLE GROUND FEATURES, AND SHOULD BE CONSIDERED APPROXIMATE.

DATUM:
ELEVATIONS HEREON ARE BASED ON NAVD88.

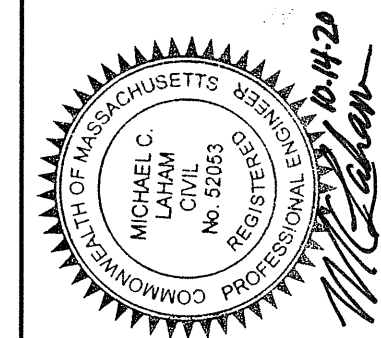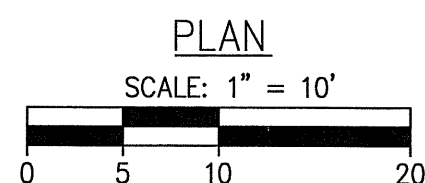

SURVEY BY: MCG
DRAFTED BY: SC
CHECKED BY: ML
APPROVED BY: ML
SCALE: 1"=30'
DATE: OCTOBER 14, 2020

REVISIONS	
NO.	DESCRIPTION

AS-BUILT PLAN OF LAND
IN
SALISBURY, MASSACHUSETTS
211 BEACH ROAD
(ASSESSOR'S MAP 28, LOT 42)
PREPARED FOR:
COBALT DEVELOPMENT

AS-BUILT
DRAWING NO.
1 OF 1