



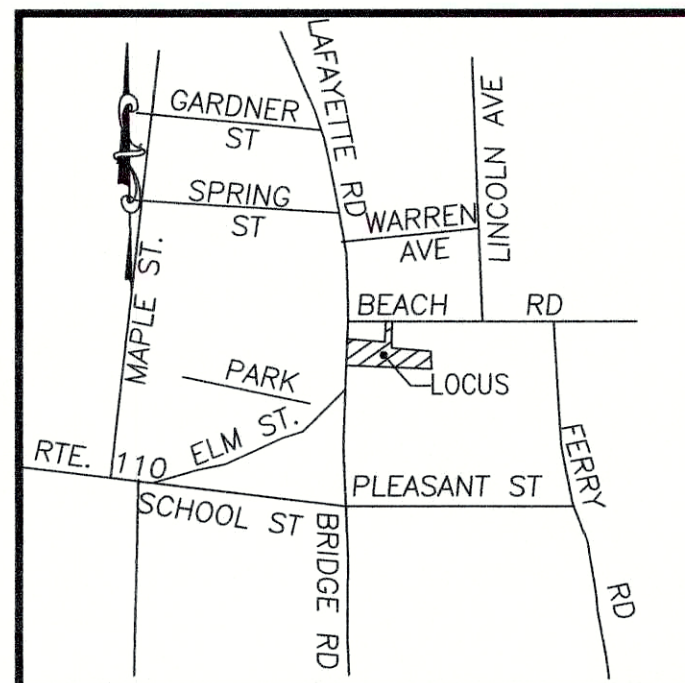


LOCUS
NOT TO SCALE

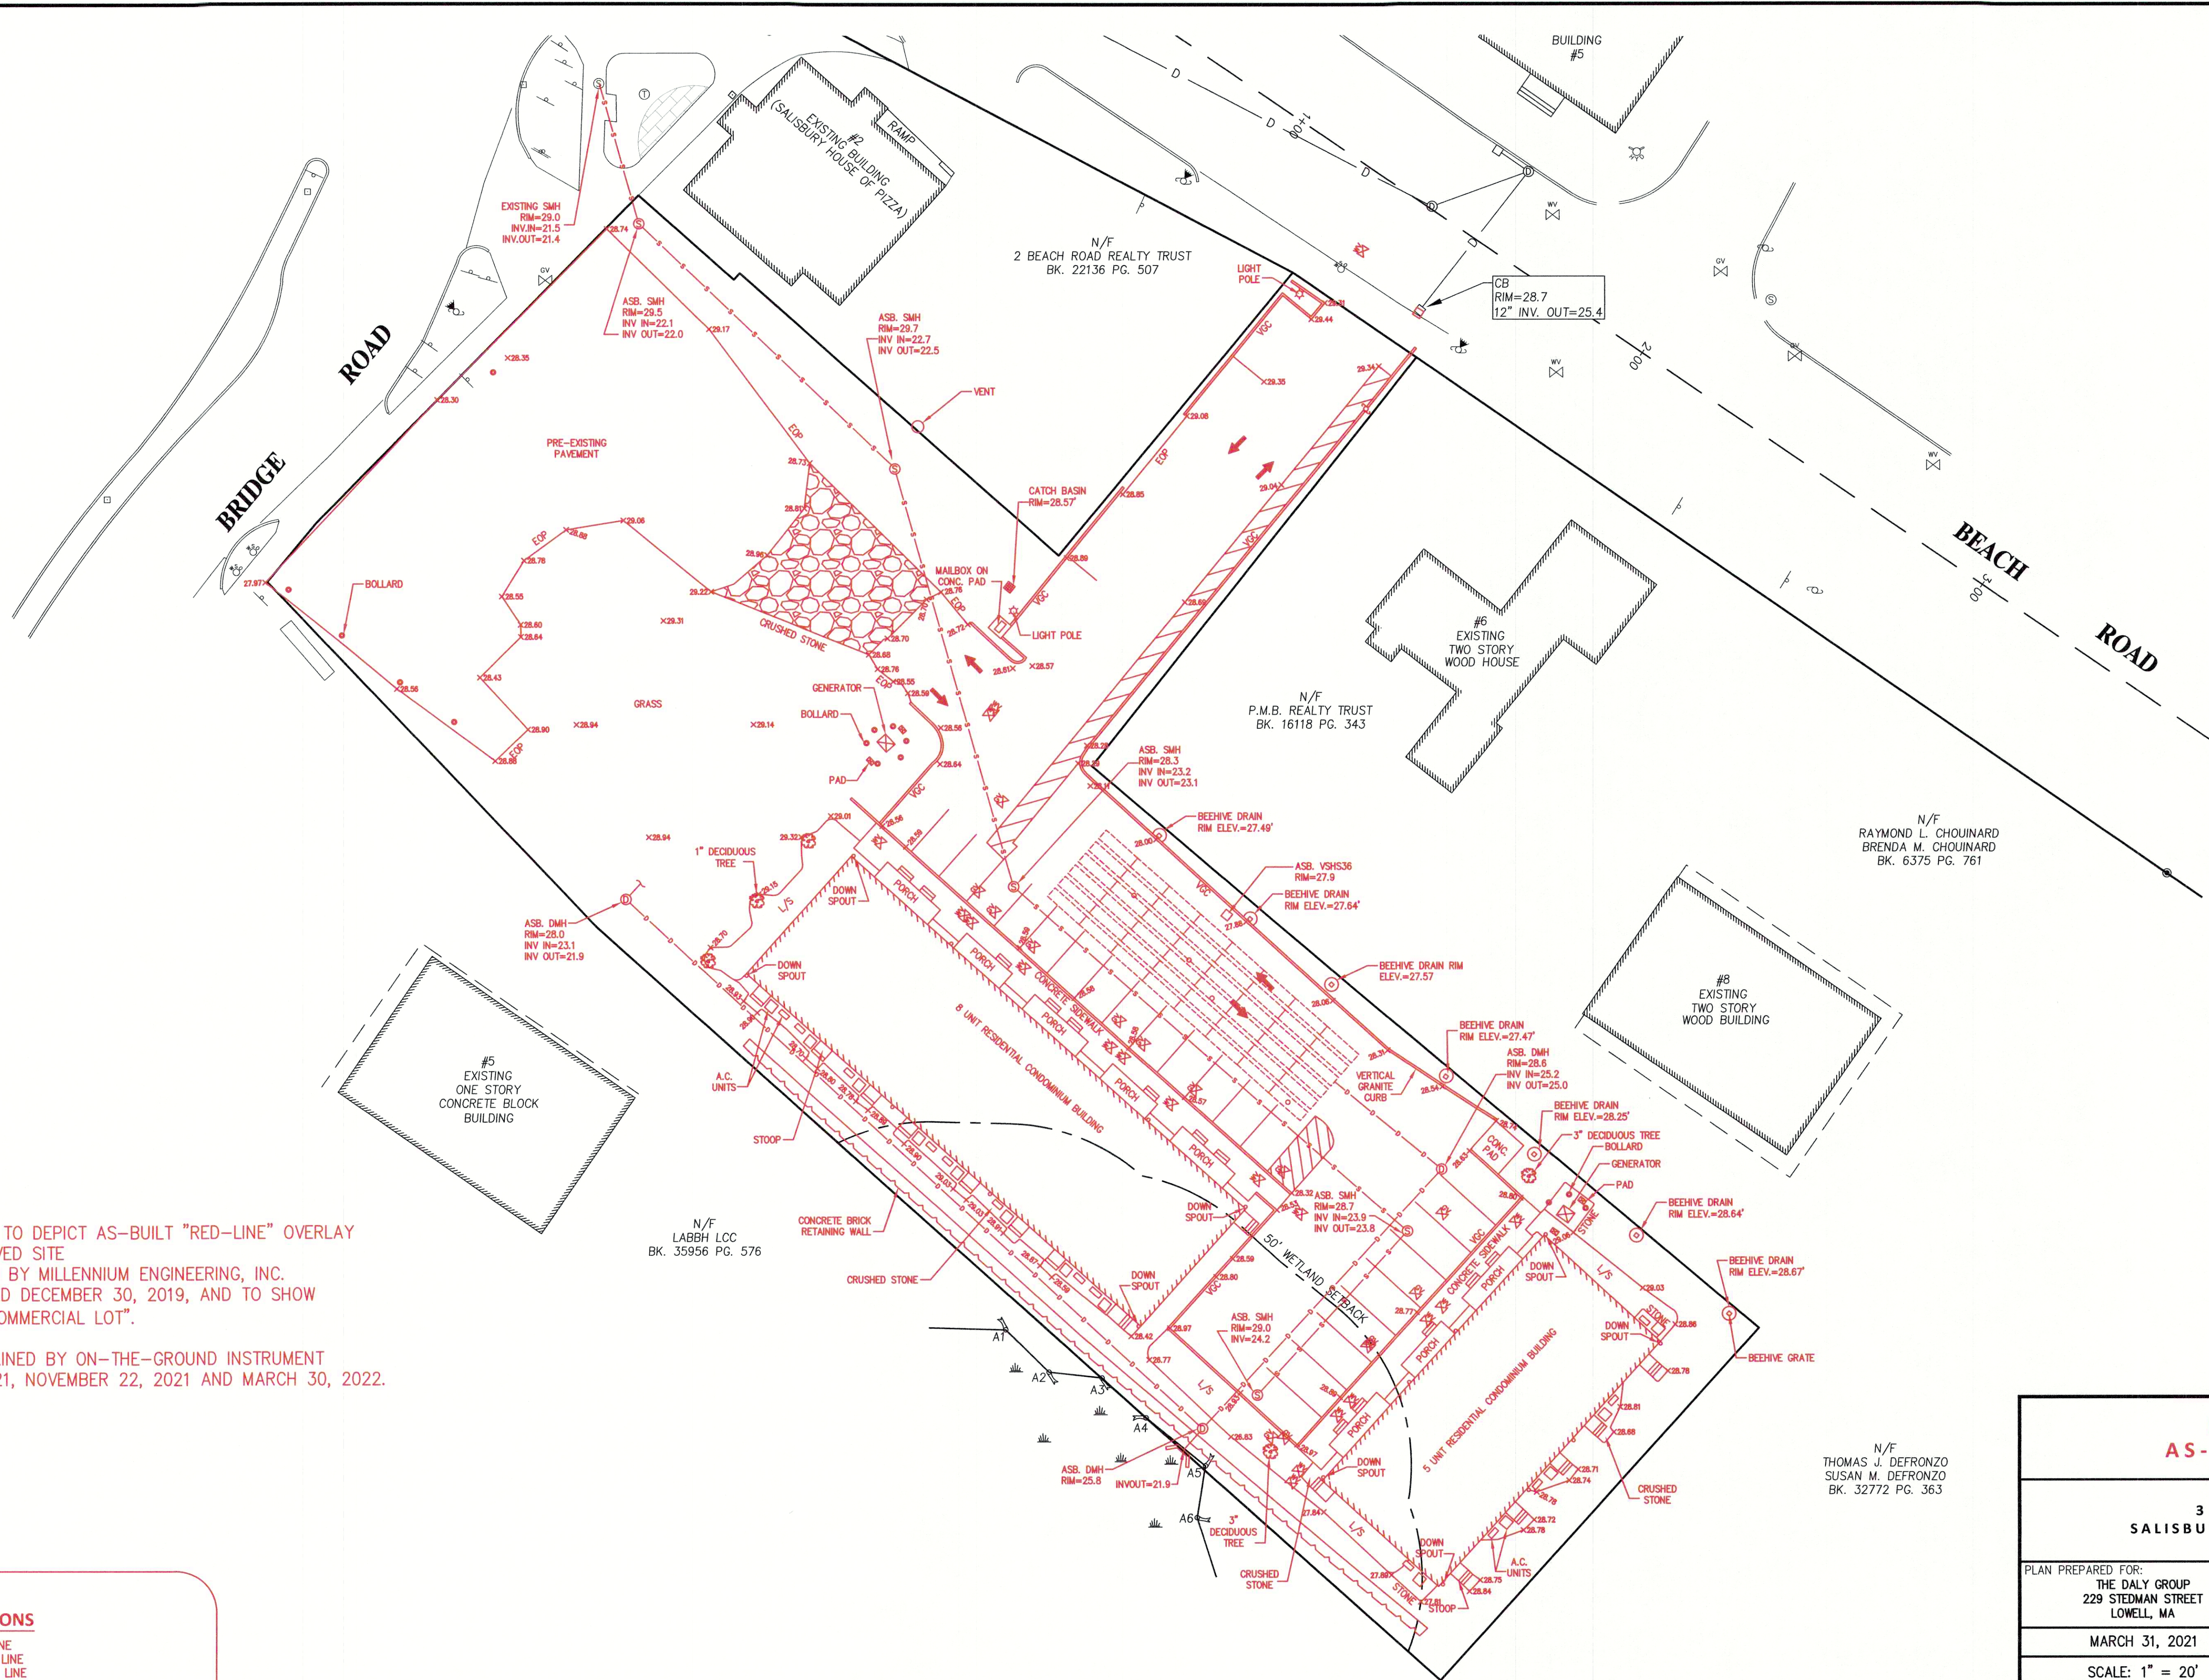


NOTE:
1. THE PURPOSE OF THIS PLAN TO DEPICT AS-BUILT "RED-LINE" OVERLAY INFORMATION ONTO THE APPROVED SITE DEVELOPMENT PLANS PREPARED BY MILLENNIUM ENGINEERING, INC. DATED MARCH 25, 2019, REVISED DECEMBER 30, 2019, AND TO SHOW PROPOSED LANDSCAPING ON "COMMERCIAL LOT".
2. AS-BUILT INFORMATION OBTAINED BY ON-THE-GROUND INSTRUMENT SURVEY ON SEPTEMBER 28, 2021, NOVEMBER 22, 2021 AND MARCH 30, 2022.

ABBREVIATIONS

-G- GAS LINE
-D- DRAIN LINE
-W- WATER LINE
-S- SEWER LINE
CONC. CONCRETE
ASB. AS-BUILT
DMH. DRAIN MANHOLE
SMH. SEWER MANHOLE
CB. CATCH BASIN
INV. INVERT
EOP. EDGE OF PAVEMENT
VGC. VERTICAL GRANITE CURB
AC. AIR CONDITIONING

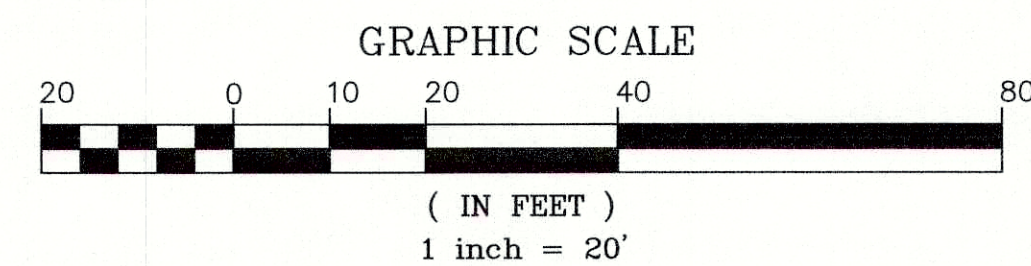

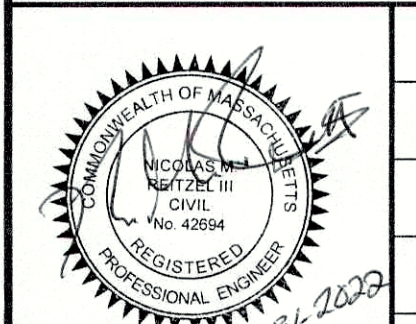INTERIM AS-BUILT PLAN			
3 BRIDGE ROAD SALISBURY, MASSACHUSETTS			
PLAN PREPARED FOR: THE DALY GROUP 229 STEDMAN STREET LOWELL, MA		 CIVIL ENGINEERING • SURVEYING 10 GEORGE STREET, UNIT 208 LOWELL, MASSACHUSETTS 01852 978-201-9390 - LANDPLEX.COM	
MARCH 31, 2021			
SCALE: 1" = 20'			
NO.	REVISION DESCRIPTION	DATE	