




NO.	DATE	DESCRIPTION	BY

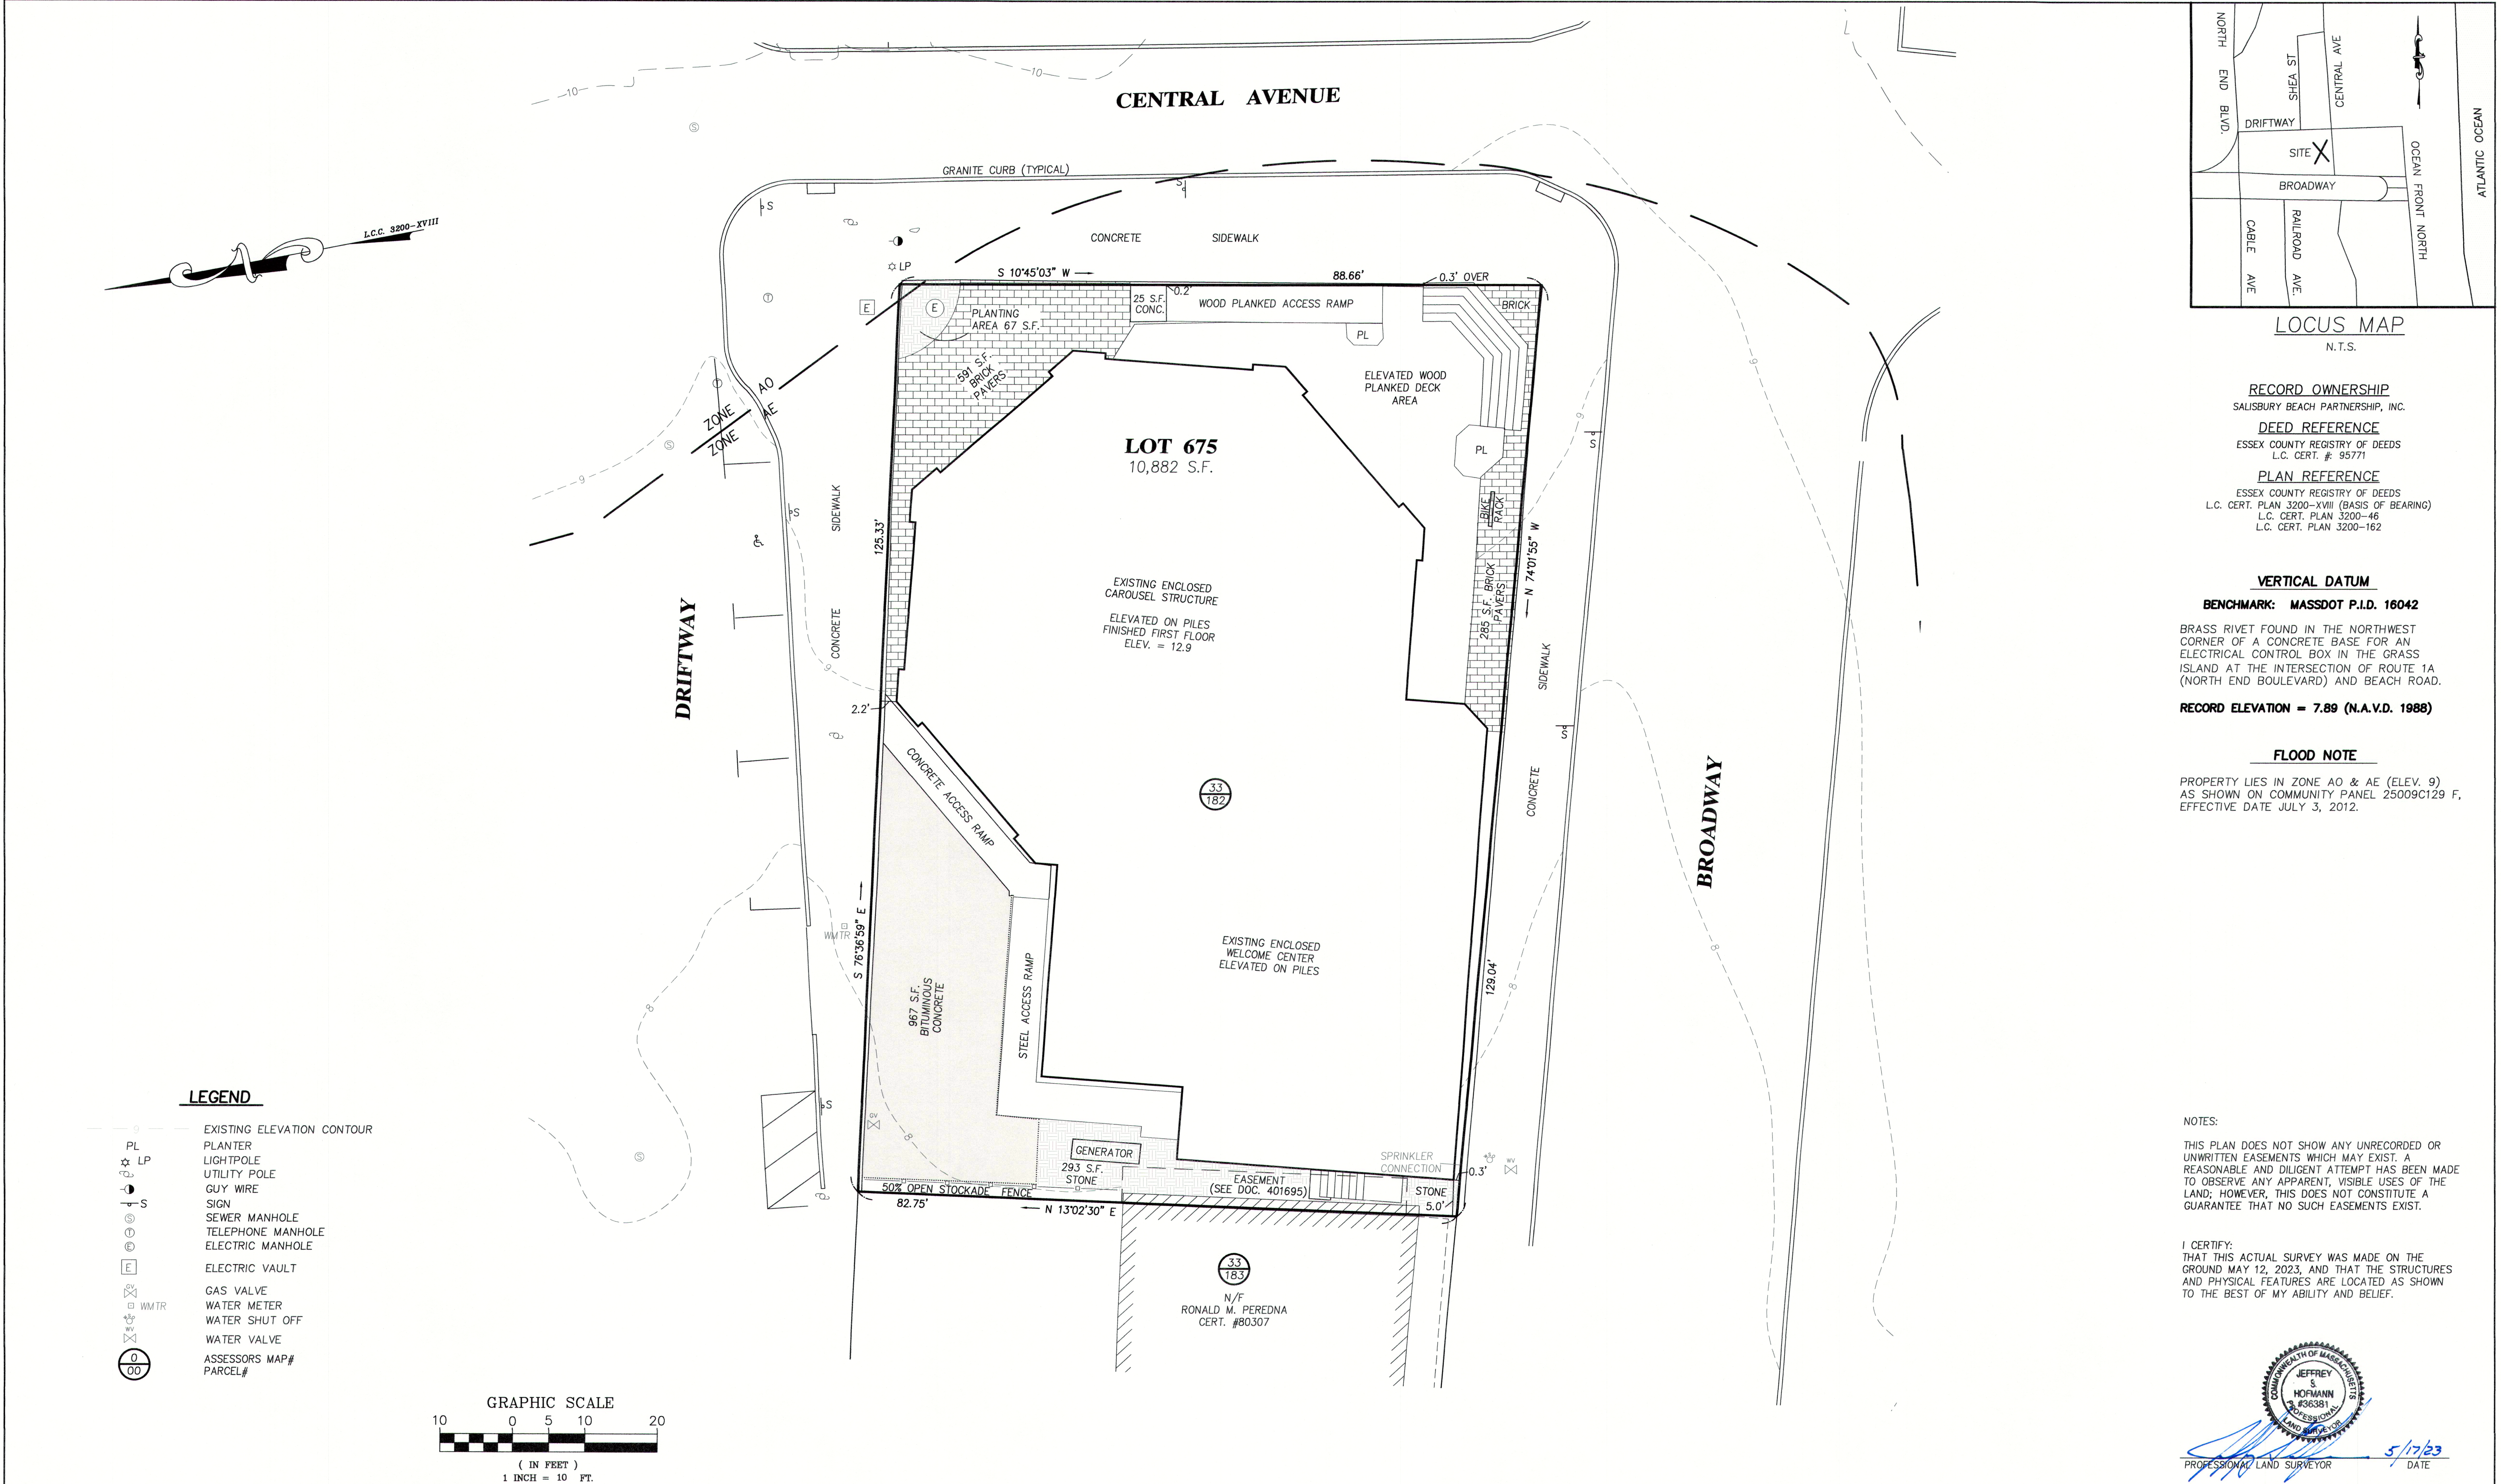

MILLENNIUM ENGINEERING, INC.
ENGINEERING AND LAND SURVEYING
62 ELM ST. SALISBURY, MA 01952 (978) 463-8980
13 HAMPTON RD., P.O. BOX 745 EXETER, NH 03833 (603) 778-0528

**AS-BUILT / CERTIFICATE
OF COMPLIANCE PLAN**
IN
SALISBURY, MA

PREPARED FOR
SALISBURY BEACH PARTNERSHIP, INC.
126 HIGH STREET
NEWBURYPORT, MA. 01950

SHOWING		
EXISTING CONDITIONS 7 BROADWAY (MAP 33, LOT 182)		
SCALE: 1"=10'	CALC. BY: J.S.H.	PROJECT: M213975
DATE: MAY 17, 2023	CHKD. BY: J.S.H.	SHEET: 1 OF 1