

ASSESSORS: MAP 13 LOT 48

REFERENCES:


DEED - BK. 37010 PG. 569

PLAN - PL. BK. 470 PL. 89

VERTICAL DATUM: N.A.V.D. 1988

LEGEND & SYMBOLS

~~~~~ TREE/BRUSH LINE

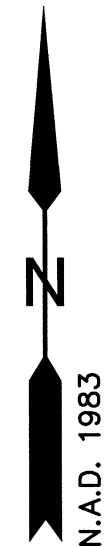

FOLLY MILL ROAD



EDGE OF PAVEMENT

STONE

GRAVEL

DIRT ROAD

DIRT ROAD

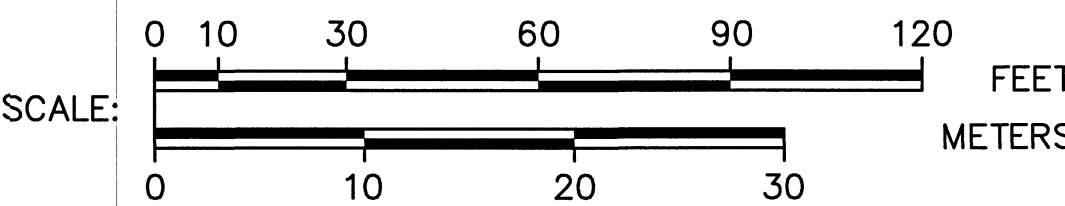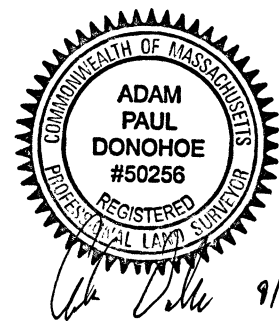

NOTE:  
• UNDERGROUND UTILITIES WERE NOT MARKED AT THE TIME OF THIS SURVEY. AN INVESTIGATION OF UNDERGROUND UTILITIES HAS NOT BEEN CONDUCTED BY DONOHUE SURVEY, INC.

AS-BUILT PLAN  
#12 FOLLY MILL ROAD  
**SALISBURY, MA**  
PROPERTY OF  
**FOLLY MILL TWELVE, LLC**

SCALE: 1" = 30' SEPTEMBER 21, 2021  
**DONOHUE SURVEY, INC.**  
363 BOSTON ST. TOPSFIELD, MA  
(978) 887-6161

PROJ. 3686